

SECTION 905 -- PROPOSAL (CONTINUED)

I (We) further propose to execute the attached contract agreement (Section 902) as soon as the work is awarded to me (us), and to begin and complete the work within the time limit(s) provided for in the Specifications and Advertisement. I (We) also propose to execute the attached contract bond (Section 903) in an amount not less than one hundred (100) percent of the total of my (our) part, but also to guarantee the excellence of both workmanship and materials until the work is finally accepted.

I (We) enclose a certified check, cashier's check or bid bond for **five percent (5%) of total bid** and hereby agree that in case of my (our) failure to execute the contract and furnish bond within Ten (10) days after notice of award, the amount of this check (bid bond) will be forfeited to the State of Mississippi as liquidated damages arising out of my (our) failure to execute the contract as proposed. It is understood that in case I am (we are) not awarded the work, the check will be returned as provided in the Specifications.

Bidder acknowledges receipt of and has added to and made a part of the proposal and contract documents the following addendum (addenda):

ADDENDUM NO. 1 DATED 6/19/2014 ADDENDUM NO. DATED
 ADDENDUM NO. DATED ADDENDUM NO. DATED

Number	Description
1	Revised Table of Contents; Revised NTB No. 4884; Add NTB Nos. 5104, 5112, & 5113; Add Addendum Section 00 91 13 for SP 907-242; Revised Section 00 01 10 in SP 907-242-31; Revised or Added Plan Sheet Nos. 2, 9, 21, & 25; Amendment EBS Download Required.

TOTAL ADDENDA: 1
 (Must agree with total addenda issued prior to opening of bids)

Respectfully Submitted,

DATE _____

 Contractor

BY _____
 Signature

TITLE _____

ADDRESS _____

CITY, STATE, ZIP _____

PHONE _____

FAX _____

E-MAIL _____

(To be filled in if a corporation)

Our corporation is chartered under the Laws of the State of _____ and the names, titles and business addresses of the executives are as follows:

_____ President	_____ Address
_____ Secretary	_____ Address
_____ Treasurer	_____ Address

The following is my (our) itemized proposal.

BWO-9718-25(001) / 502350304 LWO-9023-25(003) / 502350305 Hinds County(ies)

Revised 09/21/2005

MISSISSIPPI DEPARTMENT OF TRANSPORTATION

TABLE OF CONTENTS

**PROJECT: BWO-9718-25(001) / 502350304 &
LWO-9023-25(003) / 502350305 -- Hinds County**

901--Advertisement

904--Notice to Bidders: Governing Specs. - # 1
 Final Cleanup - # 3
 Fiber Reinforced Concrete - # 640
 Errata & Modifications to 2004 Standard Specifications - # 1405
 Federal Bridge Formula - # 1928
 Non-Quality Control/Quality Assurance Concrete - # 2818
 Reduced Speed Limit Signs - # 2937
 Alternate Asphalt Mixture Bid Items - # 3039
 Storm Water Discharge Associated w/ Construction Activities (≥ 1 and < 5
 Acres) - # 3067
 Additional Erosion Control Requirements – # 3612
 Type III Barricade Rails - # 3655
 Use of Precast Drainage Units - # 3704
 Petroleum Products Base Price - # 3893
 Safety Apparel - # 4214
 Warm Mix Asphalt (WMA) - # 4524
 Electronic Addendum Process - # 4526
 Manual on Uniform Traffic Control Devices (MUTCD) - # 4565
 Adjustments for Bituminous Materials - # 4612
 Payroll Requirements - # 4661
 Contract Time - # 4884
 Pre-Bid Meeting - # 4885
 Lane Closure Restrictions - # 4886
 Owner Furnished Materials - # 4889
 Questions Regarding Bidding - # 5044
 Additional Governing Specifications for BWO/LWO Projects - # 5104
 Clarification of Special Provision Number - # 5112
 Pre-Bid Meeting Minutes - # 5113

907-101-4: Definitions
907-102-10: Bidding Requirements and Conditions
907-103-8: Award and Execution of Contract
907-104-5: Scope of Work
907-105-7: Control of Work, W/ Supplement
907-107-13: Legal Relations & Responsibility to Public
907-107-14: Contractor's Protection Plan, W/ Supplement
907-108-30: Prosecution and Progress
907-109-6: Measurement and Payment, W/ Supplement
907-216-1: Solid Sodding
907-230-10: Tree and Shrub Planting
907-234-5: Siltation Barriers
907-237-4: Wattles
907-242-31: Shop Building
907-242-35: Water and Sewer Improvements

-- CONTINUED ON NEXT PAGE --

- 907-246-3: Sandbags & Rockbags
- 907-282-10: Automatic Irrigation System
- 907-308-4: Portland Cement Treated Courses
- 907-401-2: Hot Mix Asphalt (HMA), W/ Supplement
- 907-401-6: Warm Mix Asphalt (WMA)
- 907-403-4: Hot Mix Asphalt (HMA), W/ Supplement
- 907-403-12: Warm Mix Asphalt (WMA)
- 907-407-1: Tack Coat
- 907-501-6: Portland Cement Concrete Pavement
- 907-601-1: Structural Concrete
- 907-619-4: Construction Safety Fence
- 907-625-6: Painted Traffic Markings – Blue-ADA
- 907-626-24: Thermoplastic Blue ADA Markings
- 907-626-25: Thermoplastic Traffic Markings
- 907-630-7: Remove and Reset Signs
- 907-699-5: Construction Stakes
- 907-701-4: Hydraulic Cement
- 907-702-3: Polyphosphoric Acid (PPA) Modification of Petroleum Asphalt Cement
- 907-703-11: Aggregates
- 907-708-6: Non-Metal Drainage Structures
- 907-711-4: Synthetic Structural Fiber Reinforcement
- 907-713-3: Admixtures for Concrete
- 907-714-8: Miscellaneous Materials
- 907-720-2: Pavement Marking Materials
- 907-804-13: Concrete Bridges and Structures, W/ Supplement

SECTION 905 - PROPOSAL, PROPOSAL BID ITEMS,
COMBINATION BID PROPOSAL,
STATE BOARD OF CONTRACTORS REQUIREMENTS,
STATE CERTIFICATION REGARDING NON-COLLUSION, DEBARMENT AND SUSPENSION,
SECTION 902- CONTRACT FORM, AND SECTION 903 - CONTRACT BOND FORMS,

(REVISIONS TO THE ABOVE WILL BE INDICATED ON THE SECOND SHEET
OF SECTION 905 AS ADDENDA)

MISSISSIPPI DEPARTMENT OF TRANSPORTATION

SECTION 904 - NOTICE TO BIDDERS NO. 4884

CODE: (SP)

DATE: 06/19/2014

SUBJECT: Contract Time

**PROJECT: BWO-9718-25(001) / 502350304 &
LWO-9023-25(003) / 502350305 -- Hinds County**

The calendar date for completion of work to be performed by the Contractor for this project shall be **February 29, 2016** which date or extended date as provided in Subsection 907-108.06 shall be the end of contract time. It is anticipated that the Notice of Award will be issued no later than **July 8, 2014** and the effective date of the Notice to Proceed / Beginning of Contract Time will be **September 8, 2014**.

Should the Contractor request a Notice to Proceed earlier than **September 8, 2014** and it is agreeable with the Department for an early Notice to Proceed, the requested date will become the new Notice to Proceed / Beginning of Contract Time date.

The available productive days for this project are **239**.

MISSISSIPPI DEPARTMENT OF TRANSPORTATION

SECTION 904 - NOTICE TO BIDDERS NO. 5104

CODE: (SP)

DATE: 06/17/2014

SUBJECT: Additional Governing Specifications for BWO/LWO Projects

Bidders are advised that if the language of the AIA Document A201 in Special Provision 907-242 is in conflict with the provisions in Section 100 of the 2004 Edition of the Mississippi Standard Specifications for Road and Bridge Construction, the language in the 2004 Edition of the Mississippi Standard Specifications for Road and Bridge Construction shall control.

MISSISSIPPI DEPARTMENT OF TRANSPORTATION

SECTION 904 - NOTICE TO BIDDERS NO. 5112

CODE: (SP)

DATE: 06/18/2014

SUBJECT: Clarification of Special Provision Number

**PROJECT: BWO-9718-25(001) / 502350304 &
LWO-9023-25(003) / 502350305 -- Hinds County**

If anywhere in the plans, proposal, or specifications reference is made to Special Provision No. 907-242-25, it is understood that Special Provision No. 907-242-31 is the correct special provision number. Likewise, if anywhere in the plans, proposal, or specifications reference is made to Special Provision No. 907-242-351, it is understood that Special Provision No. 907-242-35 is the correct special provision number.

MISSISSIPPI DEPARTMENT OF TRANSPORTATION

SECTION 904 - NOTICE TO BIDDERS NO. 5113

CODE: (SP)

DATE: 06/10/2014

PROJECT: Pre-Bid Meeting Minutes

**PROJECT: BWO-9718-25(001) / 502350304 &
LWO-9023-25(003) / 502350305 -- Hinds County**

Welcome and Opening: The Pre-Bid was called so that contractors can view all owner furnished materials and have their questions answered.

Introductions were made.

Use Bidder Checklist to complete bid submittal. Pay attention to instructions about the flash drive.

An Addendum will be issued after today including the Pre-Bid Meeting Minutes and all Questions and Answers from the Pre-Bid Meeting.

Important Remarks: All bids are due by 10:00 AM on June 24, 2014.

Beginning of Contract Time will be September 8, 2014. The contractor may request an early Notice to Proceed.

Governing Specifications — Located on page 4. If there is any conflict between the Mississippi Standard Specifications for Road and Bridge Construction and the AIA General Conditions, the Mississippi Standard Specifications for Road and Bridge Construction will control.

There will be one (1) lump sum pay item for the construction of the building. There will be one (1) lump sum pay item for water and sewer improvements. All other work will be standard Pay Items covered by the Mississippi Standard Specifications for Road and Bridge Construction.

Owner Furnished Materials

- Please read Notice to Bidders No. 4889
- Owner and successful low Bidder need to jointly inspect all Owner furnished materials.
- Please read and understand Contractor's Responsibilities located on page 157.
- Pages 158-159 list all Owner furnished materials, and all materials stored in the same area that were deemed unusable.

Question: Can the rebar on site be used?

Answer: As long as it is approved by the PE, it can be used.

Question: Will structural steel need to be re-primed?

Answer: Yes. It will need to be cleaned, primed, and painted.

The current Contract for utility work on the proposed site has not been closed out, and some minor utility work will be added to this project by Addendum. The Work will include a short run of sewer pipe, lowering water line, and minor grading.

Use the GoMDOT.com website to submit questions and to view Q&As that have already been submitted.

The floor is opened for additional comments. No additional comments made.

Shop at Lab Pre-Bid Meeting Attendees June 10, 2014

Name	Company / Group	Phone #
Jim Vinson	MDOT - ASU	601-359-7292
Braetley Williams	MDOT - MND	601-359-7111
Nathan Luter	MDOT - MND	769-220-3495
Seth Winchester	MDOT - ASU	601.359.7537
Mark S. Pippert	JBWA	601.352.2699
ALAN KEGLEY	MDOT MATERIALS	601-359-1773
SHANE MARTIN	MDOT CONSTRUCTION	601-359-7319
Mike Sullivan	MDOT Materials	359-1666
Caleb Hammons	MDOT materials	601-359-9770
Earl Glenn	MDOT - Construction	601-359-7301
ANDY WILKINSON	FORDICE CONST. Co	601-636-5807
Jimmy Ironhood	Miss. A G	601-359-2600

MISSISSIPPI DEPARTMENT OF TRANSPORTATION

ADDENDUM No. 1
SECTION 00 91 13

DATE: JUNE 12, 2014

PROJECT: SHOP BUILDING FOR MATERIALS LABORATORY
JACKSON, HINDS COUNTY, MISSISSIPPI

PROJECT NUMBERS: BWO-9718-25(001) 502350
LWO-9023-25(003) 502350

PART 1 - GENERAL

- 1.01 DESCRIPTION: Bidders are hereby advised that the following changes are to be made to this Contract.
- 1.02 DRAWINGS
- A. Delete Sheet Number 2, Working Number A001 and replace with attached Sheet Number 2, Working Number A001:
1. Revisions Schedule revised to include Sheet Revisions dated 6-11-14.
- B. Delete Sheet Number 9, Working Number C1.1 and replace with attached Sheet Number 9, Working Number C1.1.
1. The existing contours and topographic survey information were modified to match the as-built submitted by S & S Excavation from the previous LWO-9023-25(002) project.
- C. Delete Sheet Number 21, Working Number C5.0 and replace with attached Sheet Number 21, Working Number C5.0.
1. The existing contours and topographic survey information were modified to match the as-built submitted by S & S Excavation from the previous LWO-9023-25(002) project. The proposed finished grade contours were modified to align with the previous mentioned as-built information. Note numbers 2 was added to note that gate valves shall be lowered to match the finish grading. Note number 3 was added to inform the Contractor that the existing water line will need to be lowered to have a minimum 3 feet of cover over the pipe. These two notes also direct the Contractor to coordinate with the City of Jackson Public Works Department when lowering these utility items.

- D. Delete Sheet Number 25, Working Number C7.0 and replace with attached Sheet Number 25, Working Number C7.0.
1. The existing contours and topographic survey information were modified to match the as-built submitted by S & S Excavation from the previous LWO-9023-25(002) project. An existing 6" SDR 26 sanitary sewer service pipe that was installed under the previous LWO-9023-25(002) project was noted to be removed and to be reused for the sanitary sewer service line for the proposed building. The new location of the sanitary sewer service pipe and the cleanouts are shown on this revised plan sheet. Note number 7 was added to notify the Contractor that they will need to field verify the inverts of the existing water and storm drainage pipes, and provide this information to the Engineer to determine inverts for the sanitary sewer service pipe. Note number 8 was added to inform the Contractor that they will need to coordinate with the City of Jackson Public Works Department when installing the water and sanitary sewer services.

*** Please note that the above mentioned three (3) plan sheets (Sheets 9, 21, and 25) are the only sheets in this set of construction plans where the existing contours and topographic survey information has been modified to reflect the as-built submitted by S & S Excavation from the previous LWO-9023-25(002) project. The other sheet in this set of construction plans reflect the original grading plan of the LWO-9023-25(002) project in which the previous Contractor did not meet the proposed grades or the exact location of some the drainage structures.

1.03 PRE-BID MEETING

- A. A Pre-Bid Meeting was held on June 10, 2014. Meeting Minutes of this meeting are in Notice To Bidders No. 5113.
- B. The Sign-In List of this meeting is also in Notice To Bidders No. 5113.
- C. Representatives from MDOT and Contractor Representatives in attendance visited the site where Owner furnished materials are stored after the meeting to observe condition of these materials and ask questions. Questions and answers to these questions are also included in the Meeting Minutes.

1.04 CLARIFICATIONS AND QUESTIONS / ANSWERS

- A. To date, no Questions have been submitted through goMDOT.com website pertaining to this Project.

PART 2 PRODUCTS (Not Used)

PART 3 EXECUTION (Not Used)

END OF SECTION

SECTION 00 01 10 TABLE OF CONTENTS

PROJECT: SHOP BUILDING FOR MATERIALS LABORATORY
JACKSON, HINDS COUNTY, MISSISSIPPIPROJECT NUMBER: BWO-9718-25(001) 502350
LWO-9023-25(003) 502350

DATE: JUNE 18, 2014

DESCRIPTION "A": This Work shall consist of all construction work necessary in constructing the Shop Building for Materials Laboratory in Jackson, Hinds County, Mississippi, in accordance with these Specifications and conforming to the Drawings.

It is the intention of these Specifications to provide the necessary items and instruction for a complete building including all code compliance. Omission of items or instruction necessary or considered standard good practice for the proper installation and construction of the building shall not relieve the Contractor of furnishing and installing such items and conforming to the building codes having jurisdiction.

SECTION NUMBER	SECTION TITLE	NO. OF PAGES
	DIVISION 00 PROCUREMENT AND CONTRACTING REQUIREMENTS	
	INTRODUCTORY INFORMATION	
00 01 10	TABLE OF CONTENTS	6
00 01 15	LIST OF DRAWING SHEETS	3
	BIDDING REQUIREMENTS	
00 21 13	INSTRUCTION TO BIDDERS	5
00 22 13	SUPPLEMENTARY INSTRUCTIONS TO BIDDERS	2
00 25 13	PRE-BID MEETING	1
00 31 32	GEOTECHNICAL DATA	1
	GEOTECHNICAL INVESTIGATION REPORT	28
	CONTRACTING REQUIREMENTS	
00 72 00	GENERAL CONDITIONS	1
	AIA DOCUMENT A201™ - 2007 AMENDED	42
00 91 13	ADDENDA	1
	DIVISION 01 – GENERAL REQUIREMENTS	
01 10 00	SUMMARY	3
	LIST OF OWNER FURNISHED MATERIALS	2
01 26 00	CONTRACT MODIFICATION PROCEDURES	2
01 29 00	PAYMENT PROCEDURES	2
01 29 73	SCHEDULE OF VALUES	1
01 31 00	PROJECT MANAGEMENT AND COORDINATION	4

01 31 19	PROJECT MEETINGS	2
01 32 00	CONSTRUCTION PROGRESS DOCUMENTATION	1
01 33 00	SUBMITTAL PROCEDURES	3
01 42 19	REFERENCES	2
01 43 00	QUALITY ASSURANCE	3
01 45 24	STRUCTURAL SPECIAL INSPECTIONS	3
01 45 29	TESTING LABORATORY SERVICES – MDOT	2
01 50 00	TEMPORARY FACILITIES AND CONTROLS	3
01 61 15	PRODUCT REQUIREMENTS	4
01 62 14	PRODUCT OPTIONS AND SUBSTITUTION PROCEDURES	4
01 73 29	CUTTING AND PATCHING	2
01 74 00	CLEANING AND WASTE MANAGEMENT	1
01 77 00	CLOSEOUT PROCEDURES	3
01 78 23	OPERATION AND MAINTENANCE DATA	7
01 78 39	PROJECT RECORD DOCUMENTS	2
01 79 00	DEMONSTRATION AND TRAINING	4
	DIVISION 02 - EXISTING CONDITIONS (Not Used)	
	DIVISION 03 - CONCRETE	
03 10 00	CONCRETE FORMING AND ACCESSORIES	4
03 20 00	CONCRETE REINFORCING	3
03 30 00	CAST-IN-PLACE CONCRETE	6
03 62 00	NON-SHRINK GROUTING	2
	DIVISION 04 – MASONRY (Not Used)	
	DIVISION 05 - METALS	
05 12 00	STRUCTURAL STEEL FRAMING	8
05 41 13	COLD-FORMED EXTERIOR STEEL STUD FRAMING	5
05 50 00	METAL FABRICATIONS	10
05 51 00	METAL STAIRS	3
	DIVISION 06 – WOOD, PLASTICS, AND COMPOSITES	
06 10 00	ROUGH CARPENTRY	4
06 40 00	ARCHITECTURAL WOODWORK	5
	DIVISION 07 - THERMAL AND MOISTURE PROTECTION	
07 21 00	THERMAL INSULATION	2
07 21 28	CELLULOSE SPRAY-ON INSULATION	3
07 26 00	VAPOR RETARDERS	2
07 27 26	FLUID-APPLIED MEMBRANE AIR BARRIERS	7
07 42 45	ALUMINUM COMPOSITE PANEL SYSTEM	6
07 56 23	FULLY REINFORCED LIQUID ROOF SYSTEM	23

07 62 00	SHEET METAL FLASHING AND TRIM	5
07 65 00	FLEXIBLE FLASHING	2
07 84 00	FIRESTOPPING	3
07 92 00	JOINT SEALANTS	4
	DIVISION 08 – OPENINGS	
08 11 13	HOLLOW METAL DOORS AND FRAMES	7
08 14 29	PREFINISHED WOOD DOORS	5
08 33 23	OVERHEAD COILING DOORS	5
08 41 13	ALUMINUM-FRAMED STOREFRONTS	5
08 71 00	DOOR HARDWARE	5
08 80 00	GLAZING	6
08 91 19	FIXED LOUVERS	4
08 92 00	GLAZED ALUMINUM CURTAINWALL	9
	DIVISION 09 - FINISHES	
09 05 15	COLOR DESIGN	3
09 29 00	GYPSON BOARD	15
09 31 13	THIN-SET CERAMIC TILING	4
09 51 00	ACOUSTICAL CEILINGS	4
09 65 00	RESILIENT FLOORING	4
09 67 27	EPOXY RESINOUS FLOORING	4
09 68 13	CARPETING	4
09 77 00	SPECIAL WALL SURFACING (FRP)	3
09 90 00	PAINTING AND COATING	8
	DIVISION 10 – SPECIALTIES	
10 11 00	VISUAL DISPLAY SURFACES	2
10 14 00	SIGNAGE	4
10 21 14	REINFORCED COMPOSITE TOILET COMPARTMENTS	3
10 21 16	SHOWER AND DRESSING COMPARTMENTS	4
10 22 14	CHAIN LINK PARTITIONS AND GATES	3
10 26 13	CORNER GUARDS	1
10 28 13	TOILET ACCESSORIES	3
10 43 15	DEFIBRILLATORS AND CABINETS	1
10 44 16	FIRE EXTINGUISHERS	2
10 51 13	METAL LOCKERS AND BENCH UNIT	3
10 56 13	METAL STORAGE SHELVING AND WORK BENCHES	2
10 56 30	PALLET STORAGE SYSTEM	2
10 57 13	HAT AND COAT RACKS	2
10 73 16	ALUMINUM CANOPY	3
10 82 15	ARCHITECTURAL SCREEN WALL	3

DIVISION 11 - EQUIPMENT		
11 31 15	RESIDENTIAL APPLIANCES & EQUIPMENT	2
11 52 16	PROJECTORS	2
DIVISION 12 - FURNISHINGS		
12 21 14	HORIZONTAL LOUVER BLINDS-METAL	3
12 48 43	FLOOR MATS	2
DIVISION 13 - SPECIAL CONSTRUCTION		
13 34 19	METAL BUILDING SYSTEMS	7
DIVISION 14 - CONVEYING EQUIPMENT		
14 45 13	HEAVY DUTY FOUR POST DRIVE-ON VEHICLE LIFT	6
14 83 16	HYDRAULIC SCISSORS LIFT TABLE	3
DIVISIONS 15 – 20 (NOT USED)		
DIVISION 21 – FIRE PROTECTION		
21 13 13	FIRE PROTECTION	16
DIVISION 22 – PLUMBING		
22 05 70	TRENCH EXCAVATION AND BACKFILL	6
22 11 16	DOMESTIC WATER PIPING	8
22 13 16	SANITARY WASTE AND VENT PIPING	5
22 13 19	DRAINS, CLEANOUTS AND DRAINAGE ACCESSORIES	2
22 15 13	COMPRESSED AIR PIPING SYSTEM	11
22 15 19	AIR COMPRESSORS AND RECEIVERS	6
22 20 13	NATURAL GAS PIPING SYSTEMS	8
22 33 13	WATER HEATER – ELECTRIC	3
22 42 00	PLUMBING FIXTURES	17
22 42 23	COMMERCIAL SHOWERS, RECEPTORS, AND BASINS	3
DIVISION 23 HEATING, VENTILATING, AND AIR-CONDITIONING		
23 05 00	MECHANICAL GENERAL	24
23 05 11	MECHANICAL SUBMITTALS	6
23 05 23	VALVES	21
23 05 29	HANGERS AND SUPPORTS FOR PIPING AND EQUIPMENT	13
23 05 48	VIBRATION ISOLATION	6
23 05 53	IDENTIFICATIN OF PIPING AND EQUIPMENT	7
23 05 93	TESTING, ADJUSTING AND BALANCING	12
23 07 13	THERMAL INSULATION FOR MECHANICAL	14

23 09 00	HVAC INSTRUMENTATION AND CONTROLS	15
23 23 00	REFRIGERNANT PIPING	10
23 31 13	DUCKWORK AND ACCESSORIES	22
23 34 00	CENTRIFUGAL FANS	8
23 36 00	TERMINAL UNITS	8
23 37 13	DIFFUSERS, REGISTERS, AND GRILLES	5
23 82 16	SPLIT-SYSTEM AIR CONDITIONING UNITS	5
23 82 39	UNIT HEATERS	3
23 83 10	ELECTRIC INFRARED RADIANT HEATERS	3
	DIVISIONS 24 – 25 (NOT USED)	
	DIVISION 26 - ELECTRICAL	
26 05 00	GENERAL PROVISIONS	3
26 05 01	CODES AND STANDARDS	1
26 05 02	ELECTRICAL SYSTEMS SCHEDULE	1
26 05 03	BASIC MATERIALS AND METHODS	2
26 05 04	ELECTRICAL SERVICE SYSTEM	1
26 05 06	ELECTRICAL POWER CONNECTIONS	3
26 05 19	CONDUCTORS	2
26 05 26	GROUNDING AND BONDING SYSTEMS	1
26 05 33	RACEWAYS AND FITTINGS	3
26 05 34	BOXES AND FITTINGS	2
26 22 00	DRY TYPE TRANSFORMERS	1
26 24 00	ELECTRICAL DISTRIBUTION SYSTEM	3
26 27 26	WIRING DEVICES	3
26 32 13	STAND-BY ELECTRIC POWER SYSTEM - NATURAL GAS	5
26 51 00	LIGHTING FIXTURES	2
	DIVISION 27 COMMUNICATIONS (Not Used)	
	DIVISION 28 ELECTRONIC SAFETY AND SECURITY	
28 05 05	SPECIAL SYSTEMS	2
28 10 00	ELECTRONIC ACCESS CONTROL & INTRUSION DETECTION	18
28 23 00	VIDEO SURVEILLANCE	14
	DIVISIONS 29 – 30 (NOT USED)	
	DIVISION 31 EARTHWORK	
31 23 11	EXCAVATION, FILL AND GRADING FOR BUILDING	6
31 31 16	TERMITE CONTROL	4
31 41 00	TEMORARY EXCAVATION SHORING OR UNDERPINNING	2
	DIVISIONS 32 – 40 (Not Used)	

	DIVISION 41 MATERIAL PROCESSING & HANDLING EQUIPMENT	
41 22 27	CEILING MOUNTED MONORAIL	6
	DIVISIONS 42 - 50 (NOT USED)	


(REVISIONS TO THE ABOVE WILL BE INDICATED ON THE SECOND SHEET
 OF SECTION 905 AS ADDENDA)

END OF TABLE OF CONTENTS

ARCHITECTURAL ABBREVIATIONS

Table of architectural abbreviations including terms like AC, ADJ., A.F.F., A.H.U., A.T., ALT., ALUM./AL., A.P.C., APPROX., ARCH., ASB., ASPH., ATTN., A.V., BD., BIT., BLDG., BLKG., BM., B.M., BOT., B.R., BRG., BRZ., B.U., B.U.R., / CH., CAB., C.B., CEM., CER., C.G., CH. BD., C.I., C.J., CLG., CLR., C.M.U., C.O., COL., CONG., CONN., CONST., CONT., COORD., CPT., C.R., C.R. CH., C.T., C.TSK., DBL., DEPT., DET./DTL., DIA., DIM., DISP., DN., DP., DS., DWGS., E., EA., E.D.F., E.F., E.I.F.S., E.J., ELEC., ELEV./EL., EMER., ENCL., E.P., EQUIP., EST., E.W., EXH., EXP., EXPO., EXST./EXIST., EXT., F.A.P., F.D., FDN., F.E., F.E.C., F.F., F.F.E., F.H., F.H.C., FIN., FL./FLR., F.O.M., F.O.S., F.P.F., F.S., FT., FTG., FURN., FURR., F.W.C., GA., GALV., G.B., G.P.D., G.C., GL., GYP., GYP. BD., H.B., H.C., H.C./HCP., HCWD., HDWE., HGT., H.M., HORIZ., HR., H.R., HVAC., I.D., INSUL., INT., INV., I.P., JAN., J.B., J.T., K.O., L.A.T., LAM., LAV., LBS., LKR., LT., LT. WT., LVR.

ARCHITECTURAL SYMBOLS

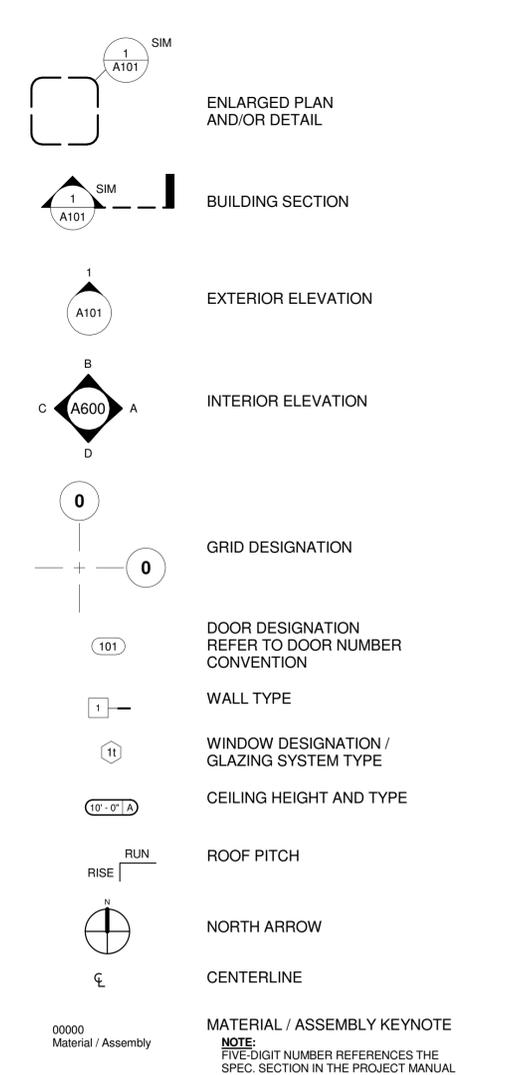

PROJECT TEAM

OWNER
MDOT
Owner Representative: Jim Vinson, AIA
Address: P.O. Box 1850
Jackson, MS 39215-1850
Phone: 601-359-7292
Email: JVinson@mdot.state.ms.us

ARCHITECTURAL
JBHM ARCHITECTS
Partner in Charge: Richard McNeel, AIA
Project Manager: Mark Pippner
Address: 308 E. Pearl St., Suite 300
Jackson, MS 39201
Phone: 601-352-2699
Fax: 601-352-2693
Email: mpippner@jbhm.com

STRUCTURAL
STRUCTURAL DESIGN GROUP
Engineer: Tom Schaeffer, P.E.
Address: 220 Great Circle Road, Suite 106
Nashville, TN 37228
Phone: 615-255-5537
Fax: 615-255-1486
Email: toms@sdg-structure.com

MECHANICAL & PLUMBING
THOMPSON COMPANY, INC.
Bill Erwin, P.E.
Address: 50 Technology Parkway South
Norcross, GA 30092
Phone: 678-538-2857
Fax: 404-364-0895
Email: dbibbs@tcieng.com

ELECTRICAL
WATKINS & O'GWYNN
Mikle Wynne, P.E.
Address: P.O. Box 16074
Jackson, MS 39236-0074
Phone: 601-982-3313
Fax: 601-982-7685
Email: hogwynn@watkins-ogwynn.com

CIVIL
NEEL-SCHAFFER
Chuck Lott, P.E.
Address: P.O. Box 22625
Jackson, MS 39225-2625
Phone: 601-948-3071
Fax: 601-948-3178
Email: chucklott@neel-schaffer.com

Table with 3 columns: No., A000, Title Sheet. Rows 1-4.

Table with 3 columns: No., C0.1, General Notes and Index of Drawings. Rows 5-19.

Table with 3 columns: No., -ECD-1, Typ Temp Erosion/Sediment Control Applications. Rows 39-50.

Table with 3 columns: No., L4.0, Planting Plan. Rows 51-56.

- Index Sheet Note: 1. Successive sheet numbering will end at (114) - E-9 Schedules and Details. 2. -CIVIL- MDOT STANDARDS - will follow the typical MDOT sheet numbering system for contract documents.

PS & E PLANS DATE: 4/15/11
FMS CON. # 502350/304000 & 305000
REVISIONS table with columns DATE, SHEET NO., BY.



INDEX OF DRAWINGS

Table with 3 columns: No., A200, Floor Plan. Rows 57-67.

Table with 3 columns: No., C0.1, General Notes and Index of Drawings. Rows 68-79.

Table with 3 columns: No., S001, Structural Notes and Drawing Index. Rows 80-92.

Table with 3 columns: No., P001, Notes, Abbreviations & Schedules - Plumbing. Rows 93-98.

Table with 3 columns: No., M001, Notes, Abbreviations & Schedules - Mechanical. Rows 99-105.


Table with 3 columns: No., E-1, Site Plan. Rows 106-114.

Table with 3 columns: No., .EC-1, Erosion Control. Rows 6140-6322.


MISSISSIPPI DEPARTMENT OF TRANSPORTATION
Shop Building For Materials Laboratory
Detailed Index
BWO-9718-25(001) AND LWO-9023-25(003) HINDS COUNTY
FILENAME: A001.dgn
DESIGN TEAM ME/TT CHECKED RHM DATE 01/28/2014

Table with 2 columns: STATE, PROJECT NO. Rows MISS, BWO-9718-25(001), LWO-9023-25(003).

MATCH LINE - WORKING NUMBER C1.2

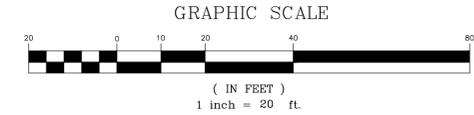

STATE	PROJECT NO.
MISS.	BWO-9718-25(001)
MISS.	LWO-9023-25(003)

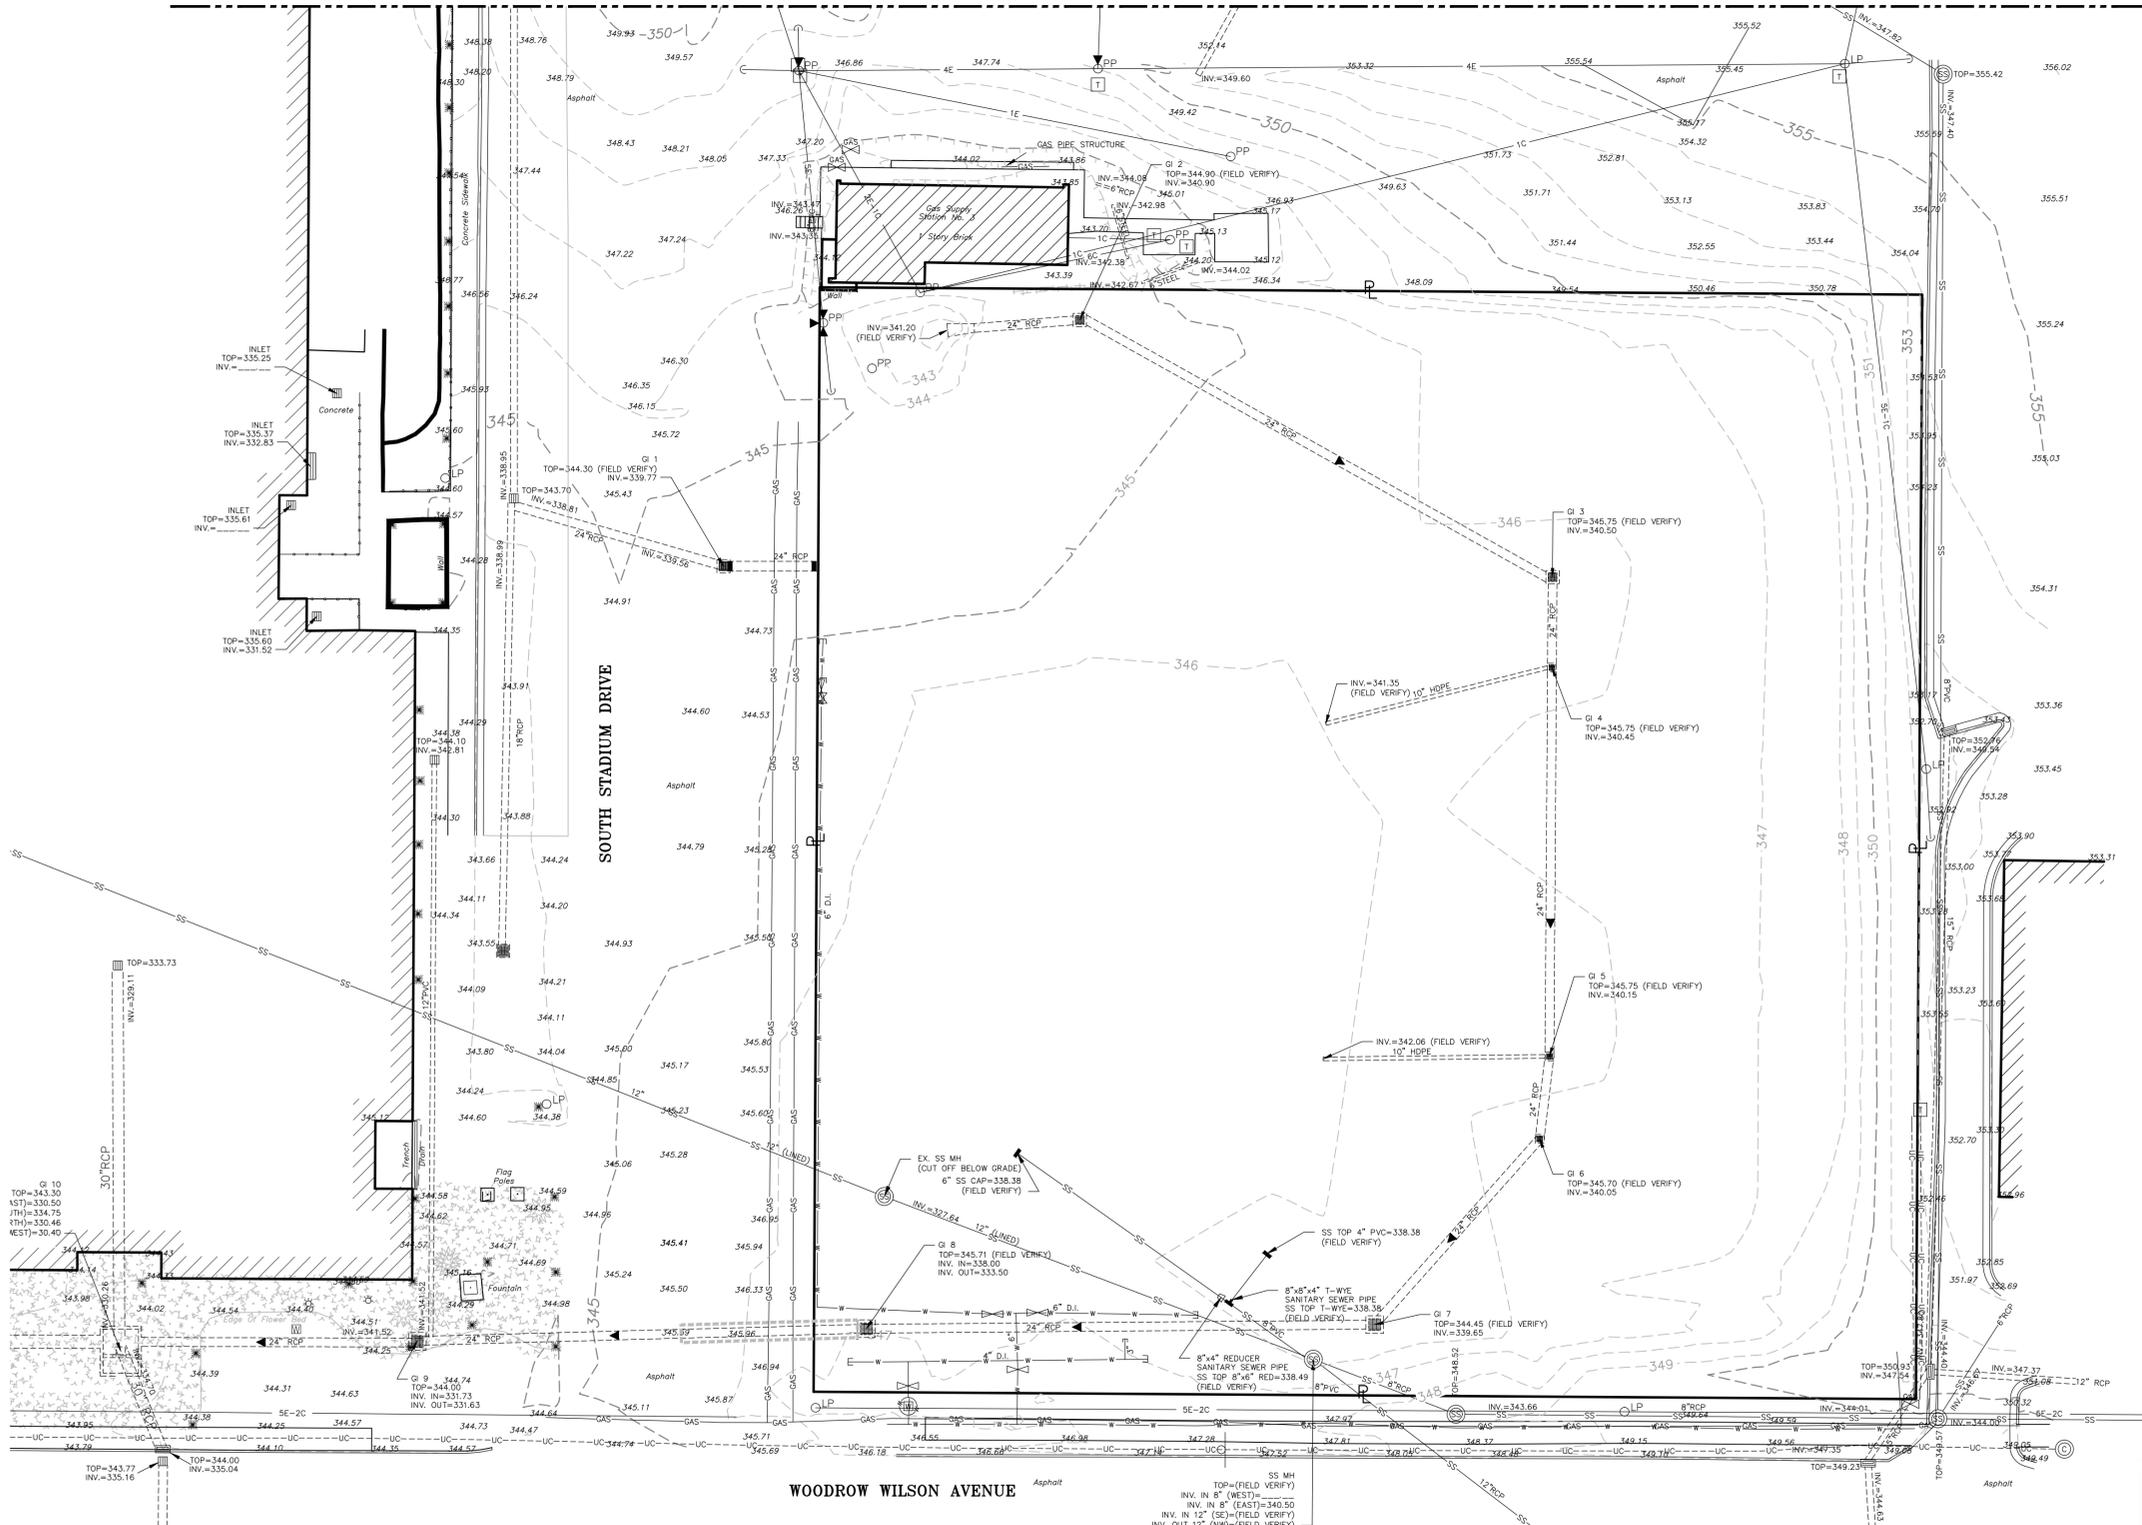

GENERAL LEGEND

- FOUND IRON ROD
- SET 5/8" IRON ROD
- PP POWER POLE
- PP POWER POLE WITH GUY WIRE
- PP POWER POLE WITH TRANSFORMER
- LP LIGHT POLE
- E ELECTRIC SERVICE BOX
- T TELEPHONE BOX
- TV CATV PEDESTAL
- G GUARD POST
- E ELECTRIC METER
- G GAS METER
- G GAS VALVE
- C CURB INLET
- D DROP INLET
- S SM STORM DRAIN MANHOLE
- C CO CLEAN OUT
- S SM SANITARY SEWER MANHOLE
- W W WATER METER
- W W WATER VALVE
- F F FIRE HYDRANT
- W W WATER FAUCET
- W W WATER SPRINKLER
- P P POST INDICATOR VALVE
- W W WATER MANHOLE
- S S SIGNS
- C C CREPE MYRTLE
- S S SHRUBS AND PLANTINGS
- T T TREES
- 4E --- OVERHEAD ELECTRIC SERVICE
- UE --- UNDERGROUND ELECTRIC SERVICE
- 4C --- OVERHEAD COMMUNICATIONS CABLE
- UC --- UNDERGROUND COMMUNICATIONS CABLE
- CATV --- CATV CABLE
- GAS --- GAS LINE
- SS --- SANITARY SEWER LINE
- SS --- SANITARY SEWER LINE (PER PLANS)
- W --- WATER LINE
- 12" SD --- STORM DRAIN PIPE
- X --- FENCE LINE
- EASEMENT LINE
- RIGHT-OF-WAY LINE
- ADJOINING PROPERTY LINE
- PROPERTY LINE
- WATER LINE
- 350 --- CONTOUR LINE
- EXISTING INLET



NOTES:
 1. IF ANY INFORMATION INDICATED TO BE FIELD VERIFIED IS FOUND TO DIFFER FROM INFORMATION SHOWN ON PLANS, NOTIFY OWNER'S ON SITE REPRESENTATIVE BEFORE PROCEEDING.

C:\Users\gboates\AppData\Local\Temp\AcPublish_52096\11518-ExstCond2.dwg
 Wed, 11 Jun 2014 5:07pm







JBHM ARCHITECTS
 2000 N. I-10
 Jackson, MS 39202
 Phone: 601.352.2900
 Fax: 601.354.1922
 www.jbhm.com

NEEL-SCHAFFER
 Solutions you can build upon

MISSISSIPPI DEPARTMENT OF TRANSPORTATION Shop Building for Materials Laboratory in Jackson, Hinds County, Mississippi Existing Conditions After the Construction of the LWO-9023-25(002) Project	
BWO-9718-25(001) AND LWO-9023-25(003) HINDS COUNTY FILENAME: 11518-ExstCond2.dwg DESIGN TEAM: Neel-Schaffer, Inc. CHECKED: DMR DATE: 1/28/2014	WORKING NUMBER C1.1 SHEET NUMBER 9

STATE	PROJECT NO.
MISS.	BWO-9718-25(001)
MISS.	LWO-9023-25(003)

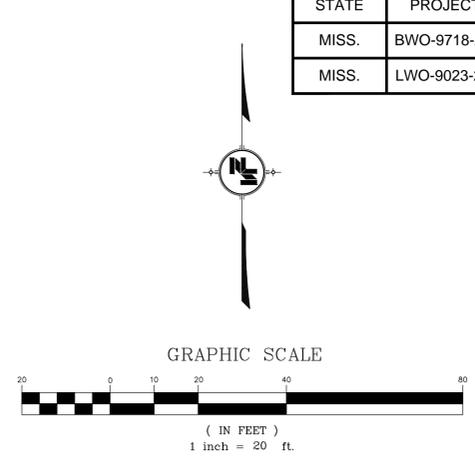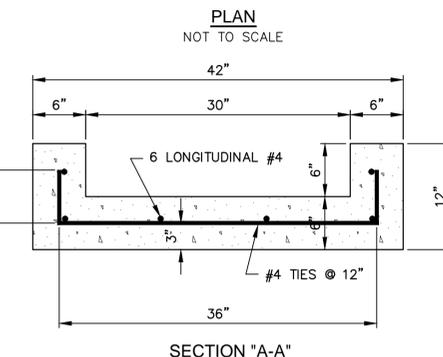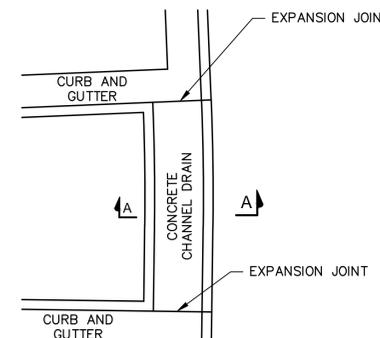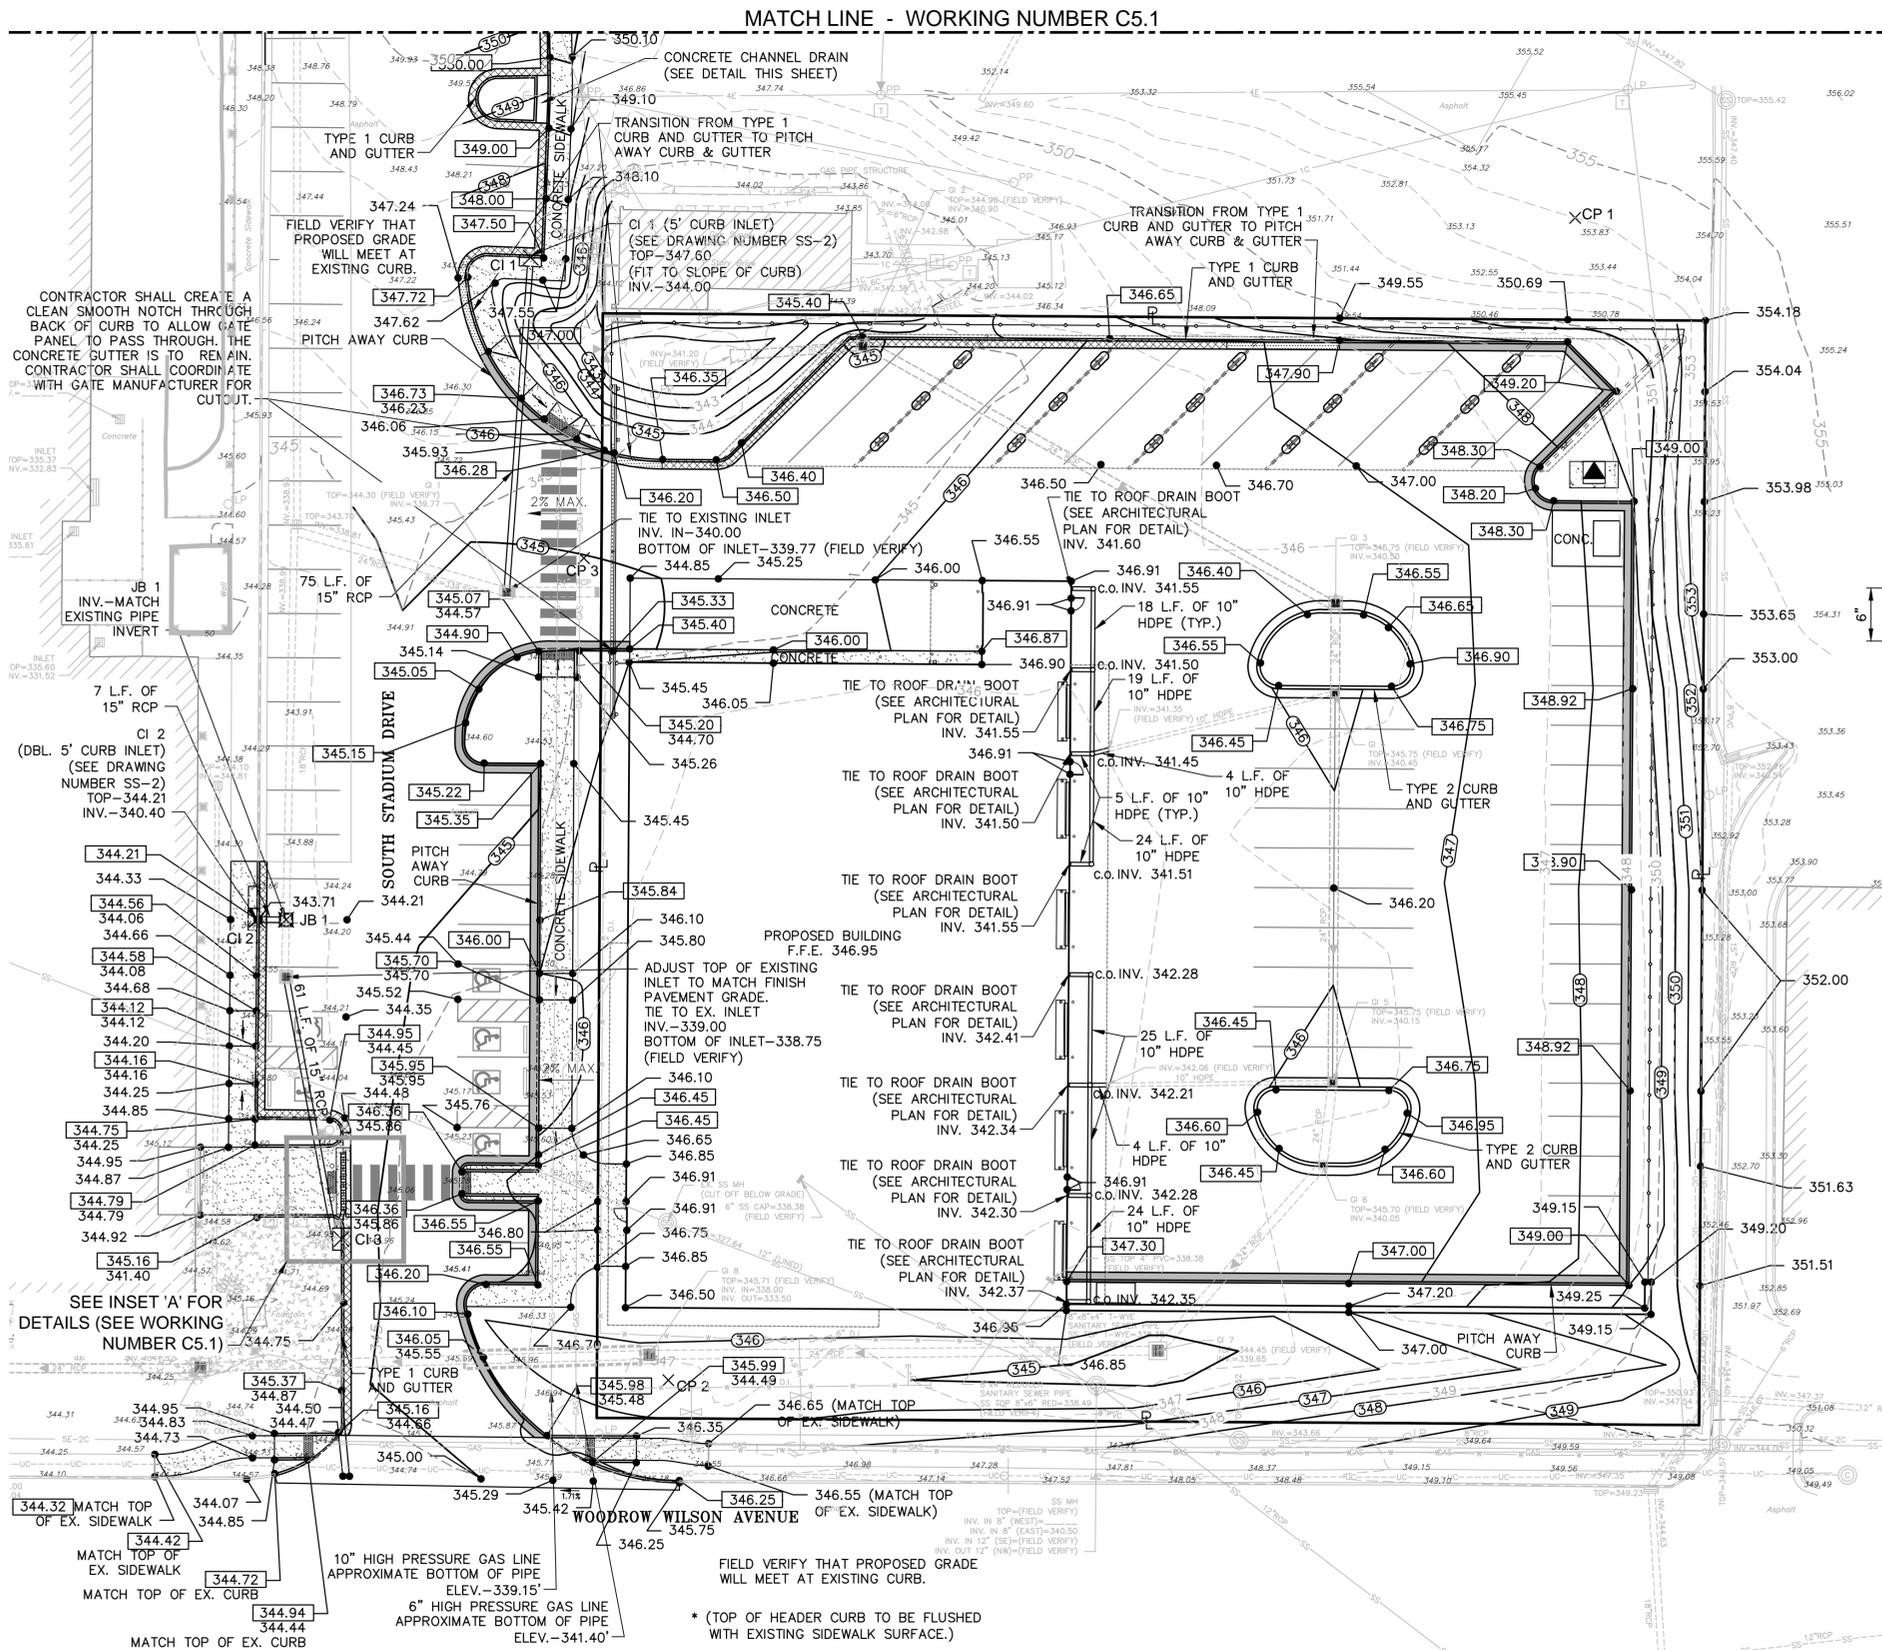

STORM DRAINAGE STRUCTURES COORDINATE POINT LISTING

POINT #	NORTHING	EASTING
CI 1	1028511.39	2343657.43
CI 2	1028361.55	2343595.41
CI 3	1028289.21	2343614.55
JB 1	1028361.49	2343602.00

CONCRETE CHANNEL DRAIN AT ISLAND
NOT TO SCALE
PAID FOR UNDER PAY ITEM NO. 907-601-B003 CLASS "B" STRUCTURAL CONCRETE, MINOR STRUCTURES & PAY ITEM NO. 602-A001 REINFORCING STEEL

LEGEND

- 330--- EXISTING CONTOURS
- 320--- FINISHED CONTOURS
- [Symbol]--- EXISTING STORM STRUCTURE AND STORM PIPE
- [Symbol]--- PROPOSED STORM STRUCTURE AND STORM PIPE
- [Symbol]--- PROPOSED TYPE 1 CURB & GUTTER
- [Symbol]--- PROPOSED TYPE 2 CURB & GUTTER
- [Symbol]--- PROPOSED PITCH AWAY CURB
- [Symbol]--- PROPOSED TRANSITION FROM TYPE 1 CURB & GUTTER TO PITCH AWAY CURB
- [Symbol]--- PROPOSED JUNCTION BOX
- [Symbol]--- PROPOSED CURB INLET AND STORM PIPE
- [Symbol]--- PROPOSED SPOT ELEVATION
- [Symbol]--- PROPOSED TOP/BACK CURB
- [Symbol]--- PROPOSED CLEAN-OUT
- [Symbol]--- EXISTING JUNCTION BOX
- [Symbol]--- EXISTING GRATE INLET
- [Symbol]--- PROPOSED CONCRETE SIDEWALK

POLYMER TRENCH DRAIN GRATE
(LOCATE AT THE MID POINT OF THE OUTSIDE EDGE OF THE TRENCH GRATE BOX)
*PAID FOR UNDER PAY ITEM NO. 907-601-B003 CLASS "B" STRUCTURAL CONCRETE, MINOR STRUCTURES. PAY ITEM NO. 602-A001 REINFORCING STEEL & PAY ITEM NO. 604-B001 GRATINGS. SEE DETAILS FOR MORE INFORMATION.

CURB INLET
(LOCATED AT THE CENTER OF THE INLET AND AT THE PROJECTED BACK OF CURB)
*PAID FOR UNDER PAY ITEM NO. 907-601-B003 CLASS "B" STRUCTURAL CONCRETE, MINOR STRUCTURES (PER C.Y.) AND PAY ITEM NO. 602-A001 REINFORCING STEEL (PER POUND). SEE WORKING NUMBER SS-2 FOR DETAILS.

JUNCTION BOX
(LOCATED AT THE CENTER OF THE JUNCTION BOX)
*PAID FOR UNDER PAY ITEM NO. 907-601-B003 CLASS "B" STRUCTURAL CONCRETE, MINOR STRUCTURES (PER C.Y.) AND PAY ITEM NO. 602-A001 REINFORCING STEEL (PER POUND). SEE WORKING NUMBER JB-1 FOR DETAILS.

LOCATION OF COORDINATE POINTS FOR DRAINAGE STRUCTURES
NOT TO SCALE

- NOTES:**
- 10" HDPE PIPE AND INSTALLATION FOR ROOF DRAINS SHALL BE ABSORBED IN PAY ITEM NO. 907-242-A006 WATER AND SEWER IMPROVEMENTS. ALL LABOR, MATERIALS, EQUIPMENT, AND OTHER INCIDENTALS SHALL ALSO BE INCLUDED IN THE ABOVE PAY ITEM.
 - ALL GATE VALVES SHALL BE LOWER TO MATCH FINISH GRADES. (CONTRACTOR SHALL COORDINATE WITH CITY OF JACKSON PUBLIC WORKS DEPARTMENT.)
 - ALL WATER LINES & BACKFLOW PREVENTER PIPING SHALL BE LOWER TO HAVE A MINIMUM COVER OF 36" OVER PIPE. (CONTRACTOR SHALL COORDINATE WITH CITY OF JACKSON PUBLIC WORKS DEPARTMENT.)

BENCHMARK DATA

CP #	DESCRIPTION	ELEVATION	COORDINATES
CP 1	CPSIR	353.90*	N 1028520.37 E 2343894.29
CP 2	CPSIR	348.32*	N 1028257.28 E 2343688.67
CP 3	CPSIR	345.77*	N 1028443.29 E 2343669.51

* BASED ON MEAN SEA LEVEL.



MISSISSIPPI DEPARTMENT OF TRANSPORTATION
Shop Building for Materials Laboratory in Jackson, Hinds County, Mississippi

Site Grading and Drainage Plan

BWO-9718-25(001) AND LWO-9023-25(003) HINDS COUNTY

FILENAME: 11518-Grading.dwg

DESIGN TEAM: Neel-Schaffer, Inc. CHECKED: DMR DATE: 1/28/2014

DATE	BY	REVISION
6/17/14	D.M.R.	REVISED ORIGINAL TOP W/ PROPOSED CONTOURS & ADDED UTILITY LINES
7/17/14	D.M.R.	REVISED ORIGINAL TOP W/ PROPOSED CONTOURS & ADDED UTILITY LINES

WORKING NUMBER: C5.0
SHEET NUMBER: 21

g:\Users\gboates\AppData\Local\Temp\AcPublish_520996\11518-Grading.dwg
 Wed, 11 Jun 2014 5:07pm


STATE	PROJECT NO.
MISS.	BWO-9718-25(001)
MISS.	LWO-9023-25(003)

NOTES:

- CONTRACTOR SHALL VERIFY PROPERTY LIMITS, TEMPORARY CONSTRUCTION EASEMENT AND NOT ALLOW ANY CONSTRUCTION OUTSIDE OF THESE LIMITS.
- ALL WORK SHOWN ON THIS PLAN SHALL BE INCLUDED IN PAY ITEM 907-242-A006 WATER AND SEWER IMPROVEMENTS, PER PLAN.
- BACKFLOW PREVENTER TO BE ABSORBED IN PAY ITEM 907-242-A006 WATER AND SEWER IMPROVEMENTS.
- ALL DUCTILE IRON PIPE JOINTS SHALL BE RESTRAINT JOINTS.
- EXISTING WATER AND SANITARY SEWER STUBOUTS ARE TO BE COORDINATED WITH PLUMBING PLAN.
- COORDINATE LOCATION OF GAS SERVICE FOR EMERGENCY GENERATOR WITH ATMOS ENERGY.
- INVERT WILL BE DETERMINED BY THE ENGINEER ONCE THE CONTRACTOR HAS FIELD VERIFIED THE INVERT OF THE WATER LINES AND STORM DRAINAGE LINE.
- ALL WATER AND SANITARY SEWER CONSTRUCTION SHALL BE COORDINATED WITH THE CITY OF JACKSON PUBLIC WORKS DEPARTMENT.





GRAPHIC SCALE

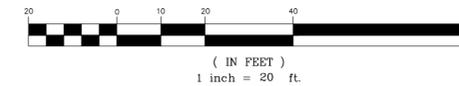

LEGEND

- °C.O. PROPOSED SANITARY SEWER CLEANOUT
- ⊗ EXISTING GATE VALVE
- ▲ PROPOSED REDUCER
- ◻ EXISTING WATER REDUCER
- ⊗ PROPOSED FIRE HYDRANT
- ⊕ PROPOSED STANDALONE SIAMESE CONNECTION
- ⊕ EXISTING TEE
- ◻ PROPOSED BACKFLOW PREVENTER
- ◻ EXISTING BACKFLOW PREVENTER

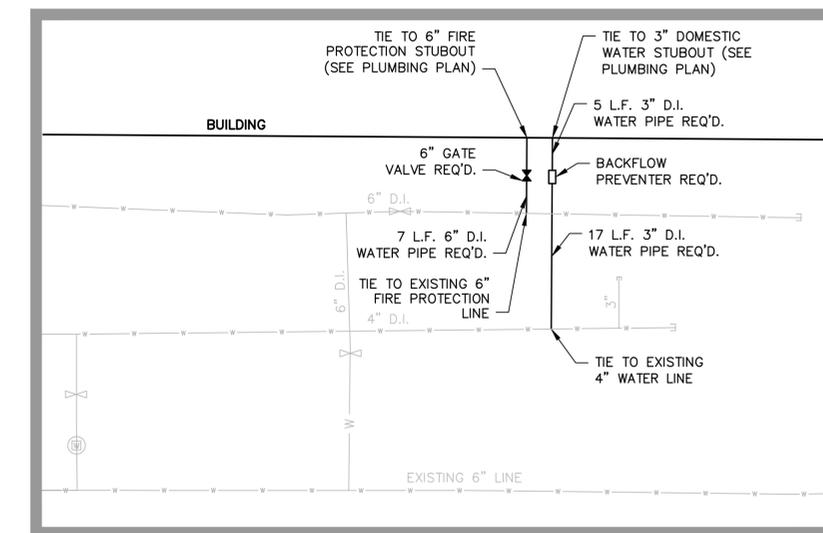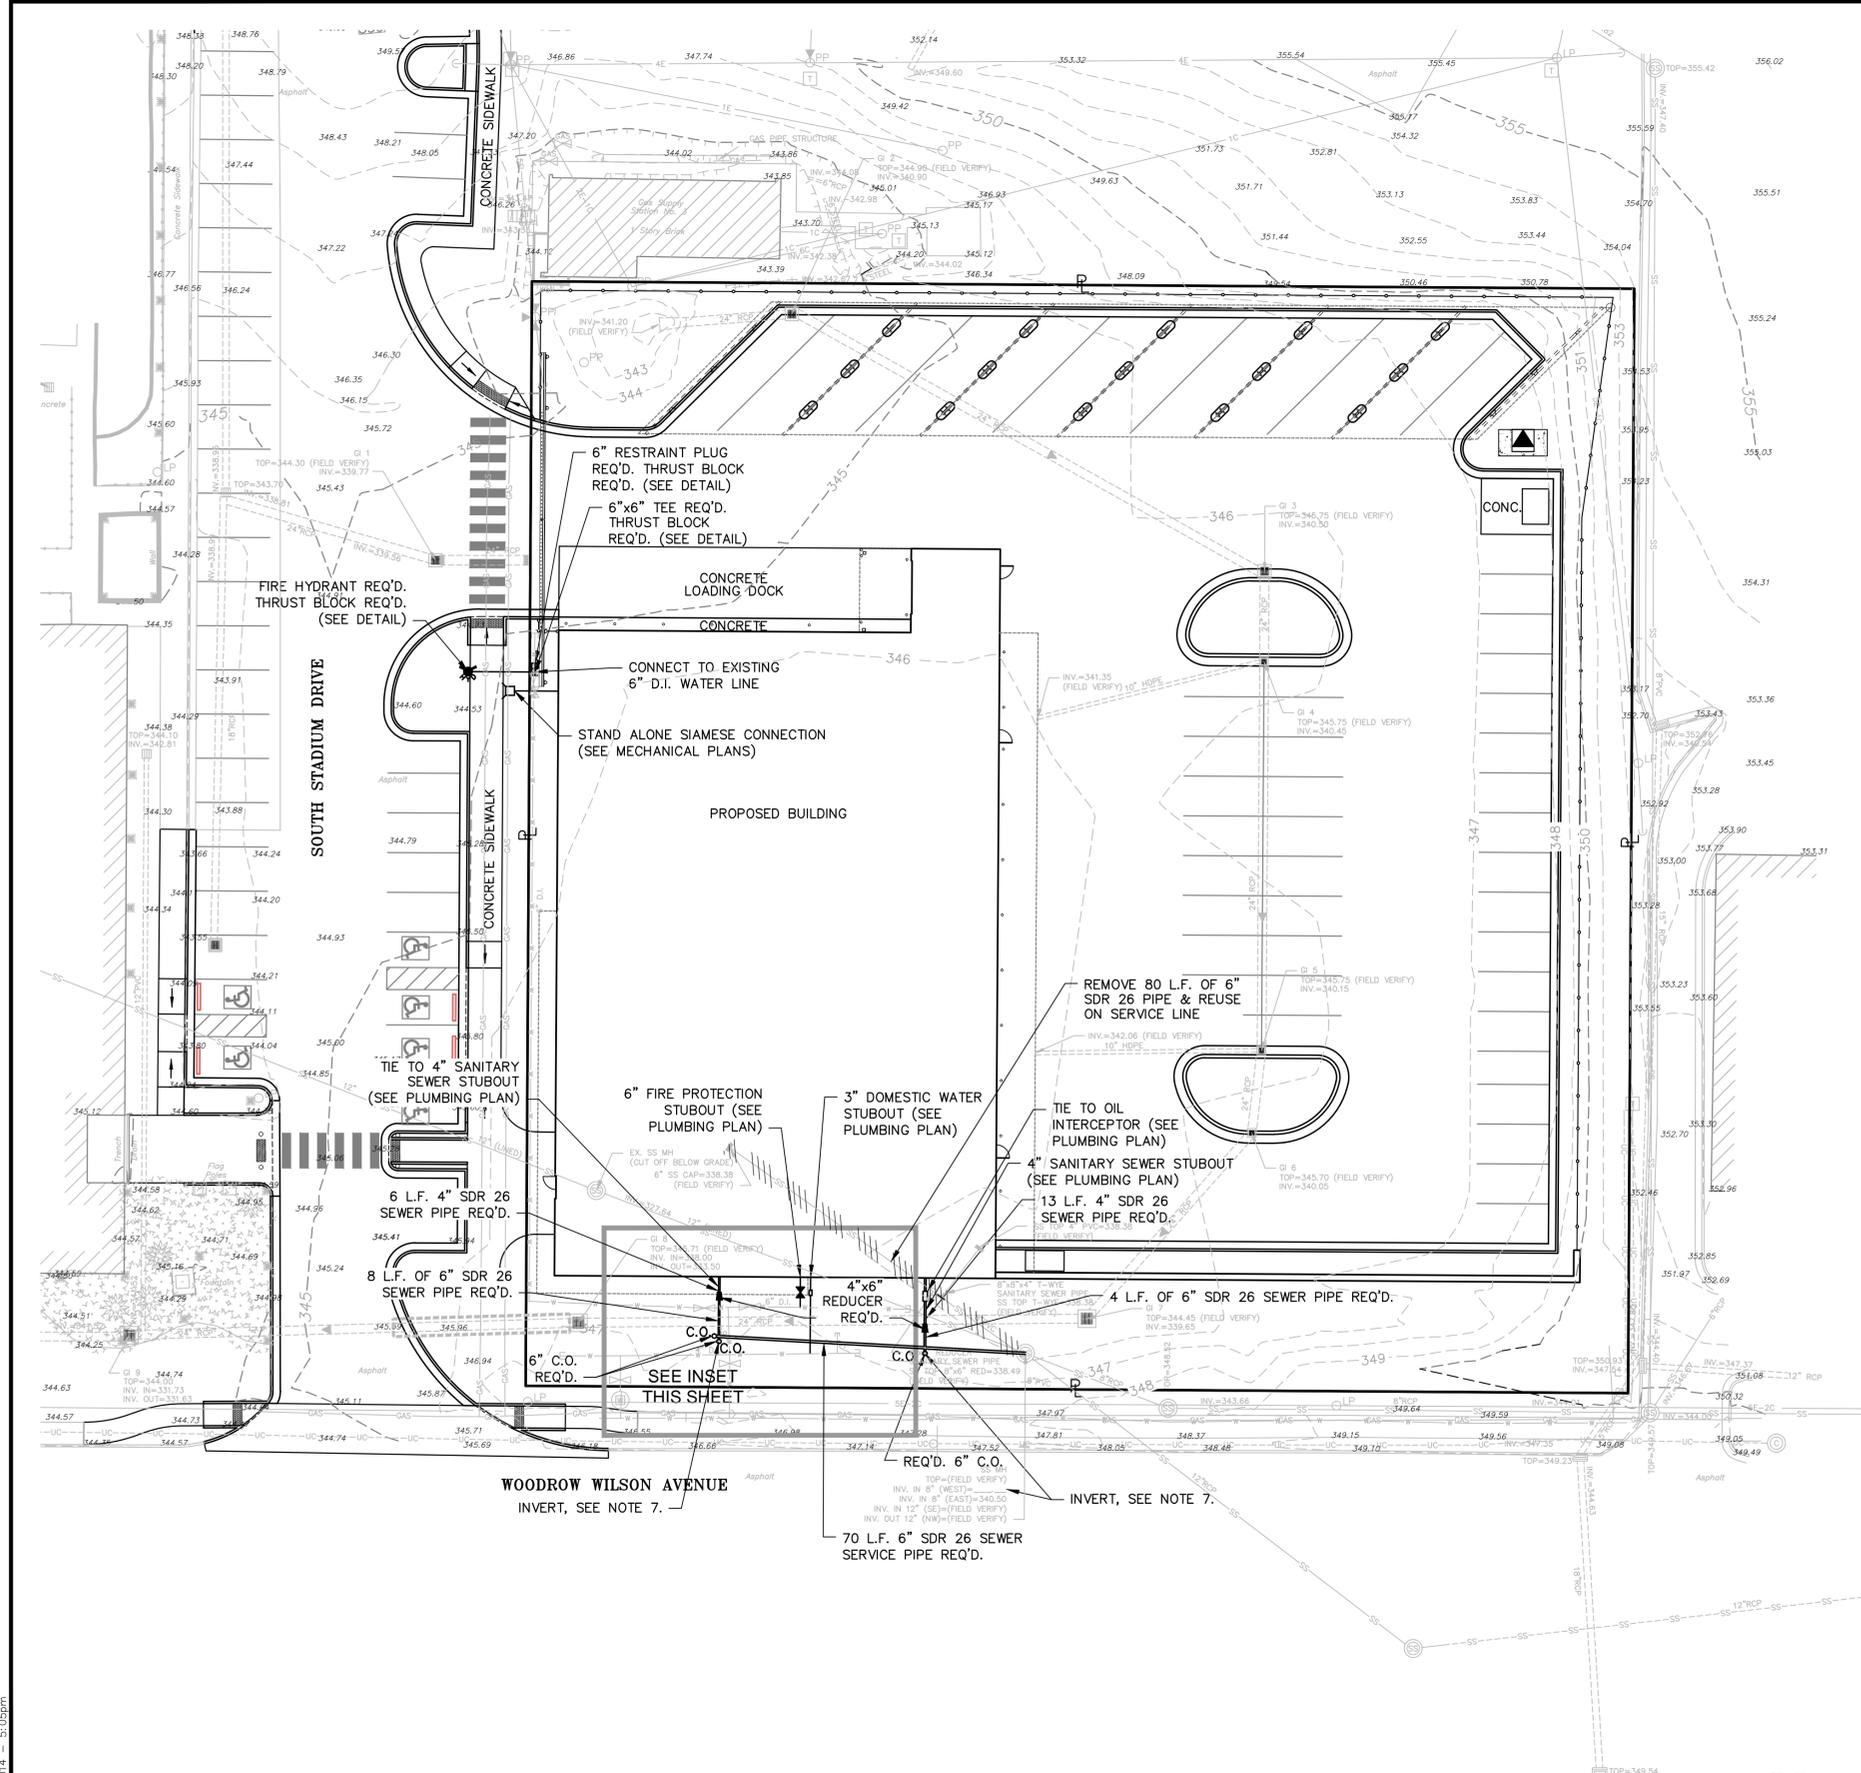

INSET
(WATER LINE CONNECTION DETAIL)
N.T.S.



MISSISSIPPI DEPARTMENT OF TRANSPORTATION		WORKING NUMBER C7.0
Shop Building for Materials Laboratory in Jackson, Hinds County, Mississippi		
Site Utility Plan		SHEET NUMBER 25
BWO-9718-25(001) AND LWO-9023-25(003) HINDS COUNTY		
FILENAME: 11518-Utility.dwg		
DESIGN TEAM: Neel-Schaffer, Inc. CHECKED: DMR DATE: 1/28/2014		

C:\Users\gboates\AppData\Local\Temp\AcPublish_52096\11518-Utility.dwg
 Wed, 11 Jun 2014 5:05pm